

# As Built Data Sheets

- Specifications Sheet



**AXH air-coolers**  
**air-x-limited**

401 E. Lowry Road Phone (918) 283-9200  
Claremore, OK 74017 Fax (918) 283-9229  
info@axh.com www.axh.com

**Proposal / Job No.** 118455  
**Date** 10/14/2011  
**Page** 1 OF 1

1	<b>Purchaser</b>	VISTA PROJECTS / MURPHY OIL CORP.	<b>Ultimate User</b>	MURPHY OIL CORP.
2	<b>Inquiry / PO#</b>	PO: 1780-009 (VISTA) / 54115097-207 (MURPHY)	<b>Destination</b>	CADOTTE PILOT CSS
3	<b># Units</b>	1	<b>Reference</b>	BOILER FEED WATER COOLER
4	<b>Assembly</b>	PACKAGED	<b>Draft</b>	FORCED
			<b>Overall Size, Ft</b>	9'W x 17'L
			<b>Est Wt</b>	8,800 LBS

**THERMAL & MECHANICAL DESIGN**

5	<b>Service</b>	BOILER FEED WATER
6	<b>Flow</b>	41580#/HR
7	<b>Fluid</b>	WATER
8	<b>Temp. In / Out, °F</b>	167.0 / 104.0
9	<b>Pressure, PSI</b>	73PSIG
10	<b>Pressure Drop, PSI</b>	8.4
11	<b>Heat Load, BTU/HR</b>	2711224
12	<b>True LMTD</b>	30.5
13	<b>Overall Rate, U</b>	162.7
14	<b>Fouling Factor</b>	.0010
15	<b>Surface, Tube / Total, Sq Ft</b>	546 / 8687
16	<b>Sections, #</b>	(1)
17	<b>Design Temp, °F Max / Min</b>	212 / -49
18	<b>MWP / Test Press, PSIG</b>	256 / 333
19	<b>Pass Arrangement</b>	CROSSFLOW
20	<b># Tube Rows</b>	3
21	<b># Tube Passes</b>	6
22	<b>Tubes, OD x BWG</b>	5/8X16
23	<b>Material</b>	SA179 STEEL
24	<b># Per Section / Length, Ft</b>	212 / 16
25	<b>Turbulators</b>	
26	<b>Accelerators</b>	
27	<b>Fins, Type</b>	HI-EFF
28	<b>Material</b>	AL
29	<b>Nozzles, Rating / Type</b>	150RF
30	<b>Material</b>	SA350LF2
31	<b>#-Inlets / Size In</b>	(1) 3
32	<b>#-Outlets / Size In</b>	(1) 3
33	<b>Headers, Type</b>	BOX
34	<b>Material</b>	SA516-70
35	<b>Corrosion Allow, In</b>	.0625
36	<b>Grooved Tubesheet</b>	DBL
37	<b>Plugs, Type</b>	SHOULDER
38	<b>Plugs Material</b>	SA350LF2
39	<b>PWHT</b>	YES
40	<b>ASME Code &amp; Nat'l Board</b>	YES
41	<b>CRN</b>	AB / BC / SK
42	<b>Add'l Specs &amp; Options</b>	
43	<b>API</b>	661*
44	<b>Louvers / Hail Screen</b>	AUTO / INT

45 **Inspection / NDT**  
**FX=** 100% X-Ray of all header seam, attachment & nozzle butt welds. **SX=** Spot X-Ray of 1 long seam & 1 end closure, per header  
**BX=** 100% X-Ray of all nozzle butt welds. **UT =** 100% UT of all header seam, attachment & nozzle butt welds. **H =** Hardness testing.




AIR-SIDE PERFORMANCE		FAN DATA		DRIVER DATA		STRUCTURAL	
46	Ambient Air Temp, In °F	86	Fan(s) 1) MOORE-10KVT-S42	Type		Guards	FAN / DRIVE
47	Elevation, Ft	2221	Blade Material ALUMINUM	V-BELT DRIVE BY (1) 25HP,			SOFT BUGSCREENS
48	Air Flow, SCFM	103,485	HP / Fan 22.3	1800RPM, 460/60/3, TEFC,			INTEGRAL HAIL GUARD
49	Outlet Air Temp, °F	109.6	Dia, In / # Blades 96 / 6	VFD COMP. MOTOR (CSA)			WARM AIR RECIRC SYSTEM
50	Min Air Temp, °F	-20	RPM 389	WITH 1.15 SERVICE FACTOR			LADDER & PLATFORM
51			Tipspeed, FPM 9776	MURPHY VS2EX VIB. SWITCH			
52	<b>Est. Noise Data:</b>	85 dBA @ 1m, 65 dBA @ 15m	Pitch, Deg 18.9				

53 **Additional Info.**  
54 \* - API 661 WITH STANDARD EXCEPTIONS & CLARIFICATIONS  
55  
56  
57  
58

# As-Built Drawings and Calculations


- Certified Drawing
- As-Built Cooler Drawing
- Shaft Detail Drawing
  - CRN Drawing
- ASME Pressure Vessel Code Calculations

ITEM	SERVICE	MAWP	CODE	NOZZLES		COUPLING V/D/P/I/TI	REF. DIMENSION		LOUVERS	BUG SCREEN	DRIVE	FAN	FINISH
				INLET	OUTLET		B	C					
1	BOILER FEED WATER (5.8 CUFT VOL.)	256 PSI @ 212/-49°F 1765 kPa @ 100/-45°C	ASME	3-150 RFWN	3-150 RFWN	(A) 1-6000 (2) .75-6000	-	-	AUTO	YES (SOFT)	ELECTRIC MOTOR DRIVE SHEAVES, BELTS, AND GUARDS BY AXH 25 HP(19 KW), 1800 RPM, 3P, 60 HZ, 460V, TEFC VFD ELECTRIC MOTOR W/ 1.15 SF, CSA, CL. 1, ZN. 2, GROUP IIA  (A) VIB. SWITCH MURPHY VS 2EX XP	96"Ø MOORE 10K, 42 VT HD 6-BLADE 18.9 PA, LH ROTATION 389 RPM @ 22.3 HP REQ'D (17 KW)  Ø2.4375" BORE WITH .625 x .3125 KWY.	STRUCTURE SIDE FRAMES GALVANIZED   HEADERS METALIZED

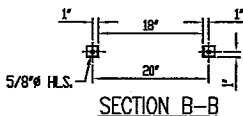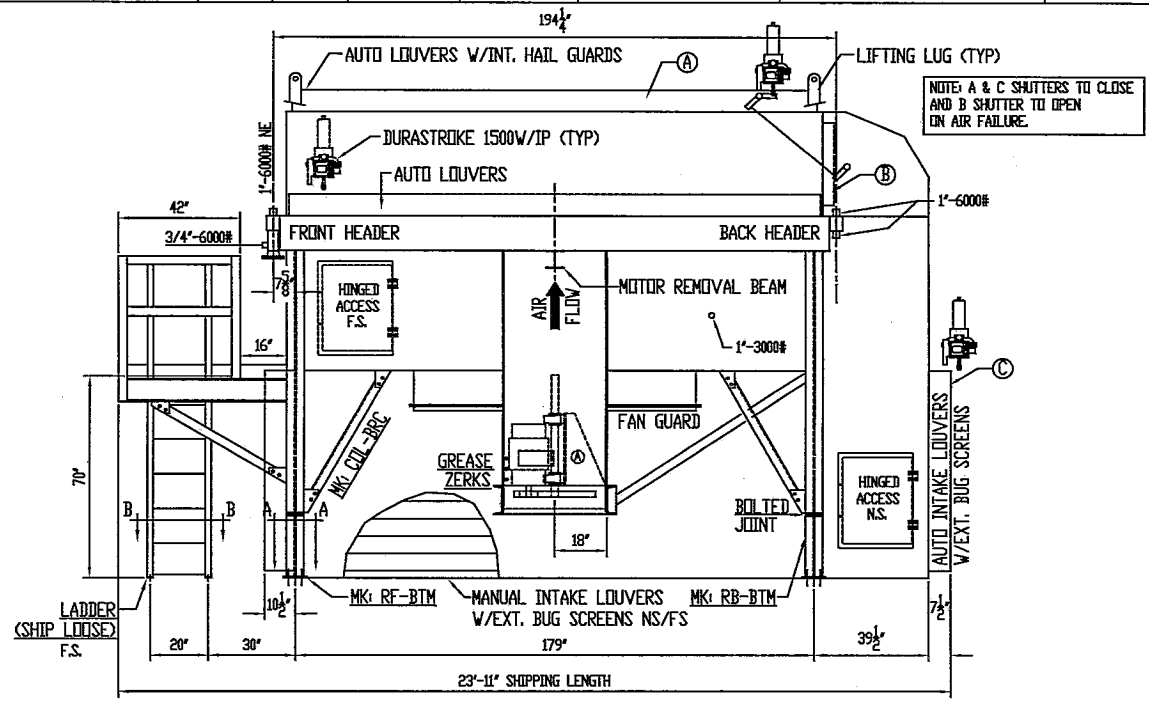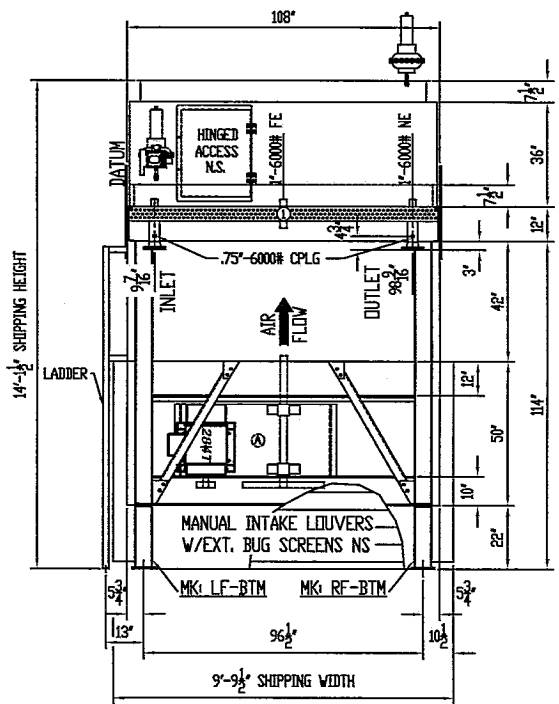

RELEASED  
FABRICATION OF THIS  
ORDER HAS BEGUN

NOTE: ALL DIMENSIONS ARE IN INCHES.

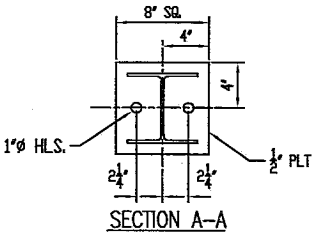

REV	REVISION DESCRIPTION	BY	CK	APP	DATE	DR:	DATE:	DATE:
5	CHG'D MOTOR DESC.	MIKE	L.W.		02/27/12	USER:	MURPHY OIL COMPANY Ltd.	
4	ADDED TO MOTOR DESC.	MIKE	L.W.		02/13/12	JOB SITE:	CADOTTE PILOT CSS	
3	ADDED CPLG IN PLENUM, LABELED CPLGS & CORRECTED kPa	MIKE	L.W.		02/08/12	JOB NO.:	118455	
2	ADDED MOTOR REMOVAL BEAM	MIKE	L.W.		01/24/12	WORK ORDER NO.:	-	
1	ADDED CUSTOMER COMMENTS & RELEASED	MIKE	L.W.		01/18/12	DR:	J.J.	DATE: 12/19/11
						CK:	J.S.	DATE: 12/29/11

FOR: MURPHY OIL CANADA ESTIMATED DRY WEIGHT 13,100# (SHIPPING)

P.O. NO: 1780-009 (Vista)  
54119097-207 (Murphy)

CUST. TAG NUM: AC-5020

USER: MURPHY OIL COMPANY Ltd.

JOB NO: 118455

WORK ORDER NO: -

DR: J.J. DATE: 12/19/11

CK: J.S. DATE: 12/29/11





CERTIFIED DRAWING FOR:  
MODEL 96BZF-R QUANTITY: 1


DWG. NO. 118455-CRT

SCALE: FULL DATE: 12/19/2011 REV 5

ITEM	SERVICE	MAWP	CODE	NOZZLES		COUPLING V/D/P/I/TI	REF. DIMENSION		LOUVERS	BUG SCREEN	DRIVE	FAN	FINISH
				INLET	OUTLET		B	C					
1	BOILER FEED WATER (5.8 CUFT VOL.)	256 PSI @ 212/-49°F 12.26 kPa @ 100/-45°C	ASME	3-150 RFWN	3-150 RFWN	(4) 1-6000 (2) .75-6000	-	-	AUTO	YES (SOFT)	ELECTRIC MOTOR DRIVE SHEAVES, BELTS, AND GUARDS BY AXH 25 HP (19 KW), 1800 RPM, 3P, 60 HZ, 460V, TEFC VFD ELECTRIC MOTOR (CSA) W/ 1.15 SF  ⓐ VIB. SWITCH MURPHY VS 2EX XP	96" Ø MOORE 10K, 42 VT HD 6-BLADE 18.9 PA, LH ROTATION 389 RPM @ 22.3 HP REQ'D (17 KW)  Ø2.4375" BORE WITH .625" x .3125 KWY.	STRUCTURE SIDE FRAMES GALVANIZED   HEADERS METALIZED

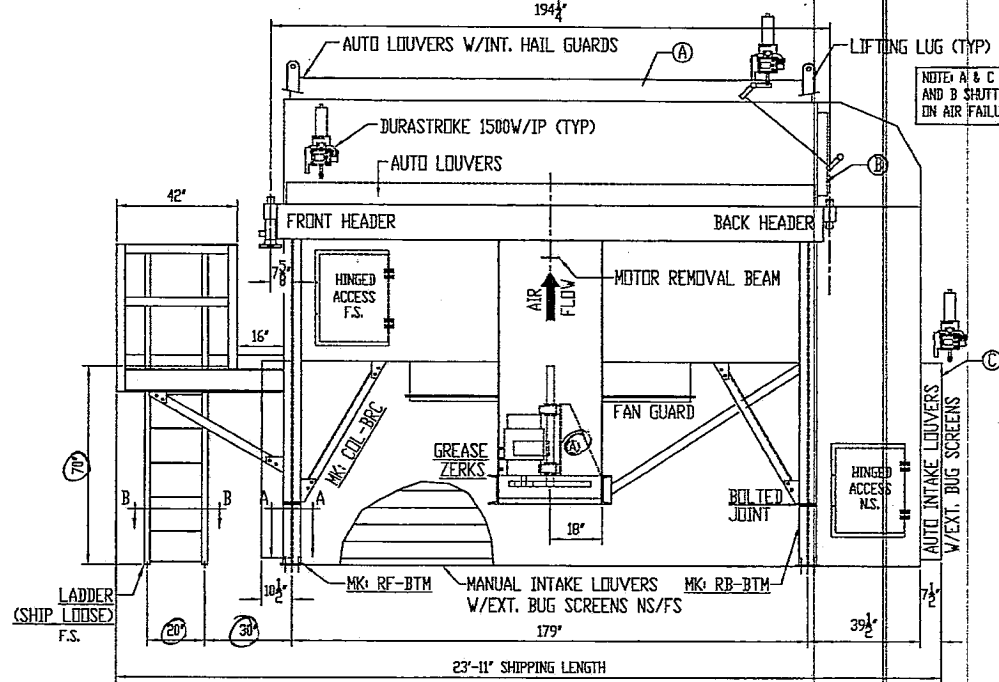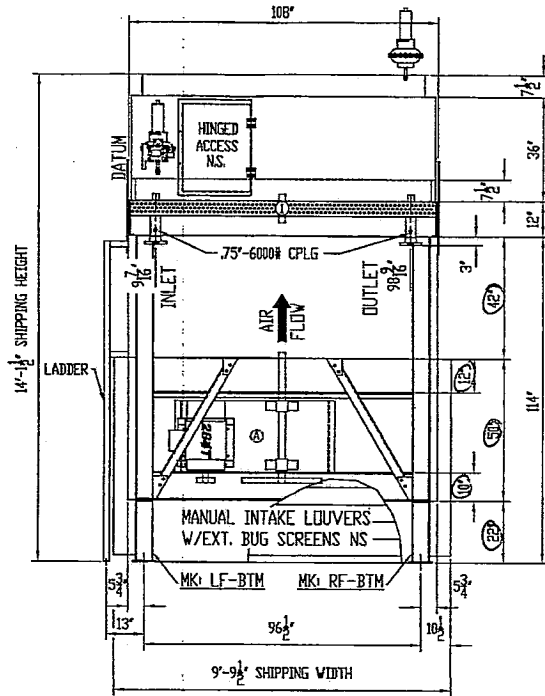


NOTE A & C SHUTTERS TO CLOSE AND B SHUTTER TO OPEN ON AIR FAILURE.

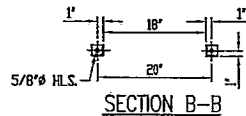

NOTE: ALL DIMENSIONS ARE IN INCHES.

RELEASED  
FABRICATION OF THIS  
ORDER HAS BEGUN

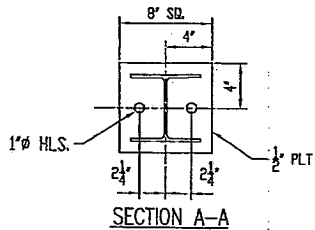

						FOR: MURPHY OIL CANADA ESTIMATED DRY WEIGHT 13,100# (SHIPPING)					
						P.O. NO: 1780-009 (Vtd) 54118097-207 (Murphy)					
						CUST. TAG NUM: AC-5020					
						USER: MURPHY OIL COMPANY Ltd.					
						JOBSITE: CADOTTE PILOT CSS					
						JOB NO: 118455					
						WORK ORDER NO: -					
						DR: J.J. DATE: 12/19/11					
						DATE: 12/29/11					
						SCALE: FULL					
						DATE: 12/19/2011					
						REV 2					




CERTIFIED DRAWING FOR:  
MODEL 96BZF-R QUANTITY: 1

DWG. NO. 118455-CRT

KP 322-R

WISCO  
W O R  
Initials: [Signature]  
Date: 3/20/12  
117

BILL OF MATERIAL					
MARK	QTY	DESCRIPTION	WIDTH	LENGTH	WEIGHT
165	1	2.4375" DIA. (C1045 MATERIAL)		3'-7 1/2"	58
167	2	KEYSTOCK - 5/8" SQUARE		4 1/2"	1
TOTAL WEIGHT					59

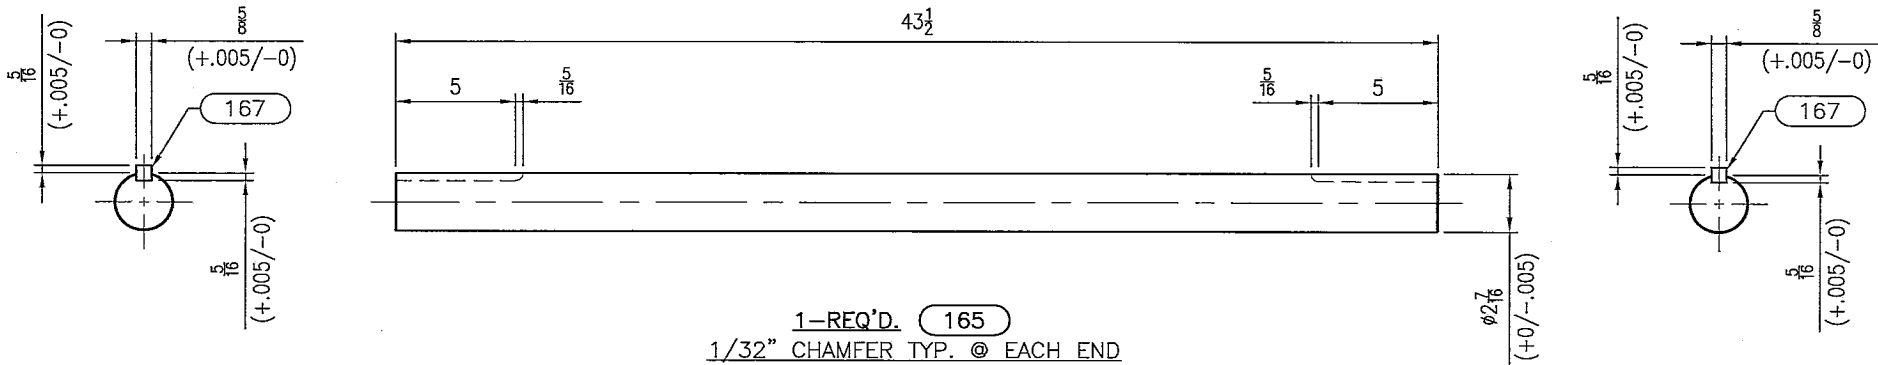


1-REQ'D. 165  
1/32" CHAMFER TYP. @ EACH END



CUSTOMER:	DRAWN BY: <i>GB</i>	CHECKED BY: <i>JB</i>
P.O. NO.:	SCALE: 1=5	
PROJECT: 118455 (1-UNIT)	DATE: 01/27/2012	
DESCRIPTION: 2-7/16" SHAFT DETAIL 96BZF-R	JOB NUMBER: 118455	SHEET: SHD
LOCATION:		REV. NO.: 0


REV	DESCRIPTION	BY	CK'D	DATE

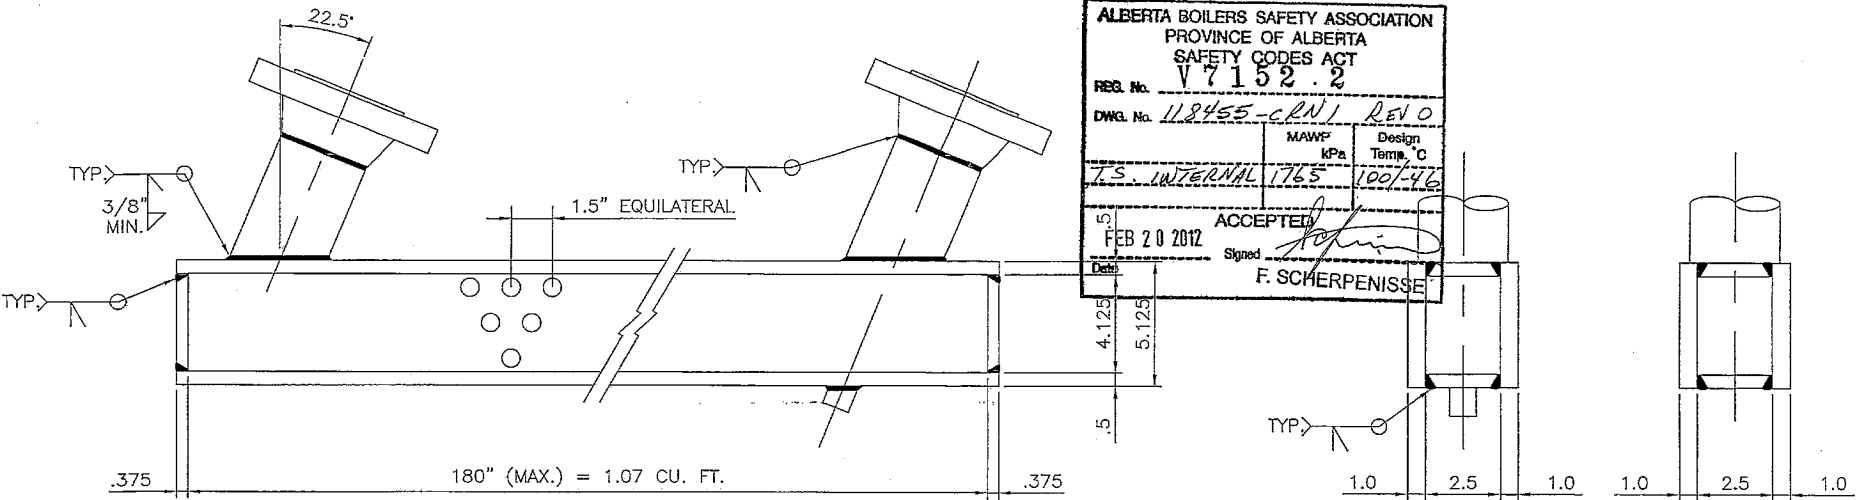



NOTE: DIMENSION "B" IS ACTUAL WELD BEVEL PREPARATION FOR FABRICATION. DIMENSION "02" REPRESENTS THE REQUIRED AMOUNT OF FUSION PER APPENDIX 28.

CROSS SECTION - SIDE VIEW

CROSS SECTION - END VIEW

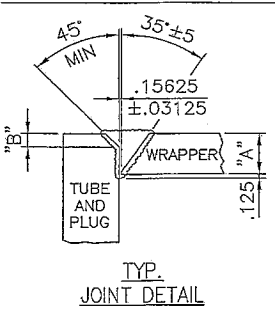

"A"	"B"
.375"	NONE
.5"	NONE
.625"	NONE
.75"	.125
.875"	.125
1.0"	.125
1.125"	.1875
1.25"	.1875
1.375"	.25"
1.5"	.25"
1.625"	.375"
1.75"	.375"
2.0"	.5"
2.25"	.5"
2.5"	.625"
2.75"	.625"
3.0"	.6875"

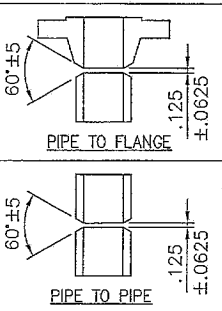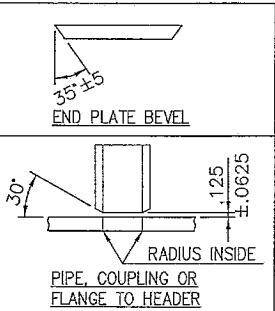

WELD PROCEDURES (LOW TEMP.)

≤ 1/2" P1-P1-11	≤ 1/2" P1-P1-11	≤ 1/2" P1-P1-10	S.S. P1-P8-03	≤ 1/2" P1-P1-11	≤ 2" NPS P1-P1-14
≥ 5/8" P1-P1-08	≥ 5/8" P1-P1-08	≥ 5/8" P1-P1-07	C.S. P1-P1-11	≥ 5/8" P1-P1-08	≥ 5/8" P1-P1-08

NOTE: VESSELS CONSTRUCTED UNDER THIS REGISTRATION SHALL BE ASME CODE STAMPED "U" & REGISTERED WITH THE NATIONAL BOARD

MATERIALS		DESIGN INFORMATION	
PLATE	SA 516-70N	DESIGN PRESSURE	256 P.S.I.
FLANGES	3"-150# RFWN SCH 160 (SA-350-LF2 CLASS-1)	DESIGN TEMPERATURE	212/-50F
PIPE	3" SCH 160 (SA-333 GR.6)	HYDROSTATIC TEST	333 P.S.I.
TUBES	.625" Ø x .060" MIN. WALL (SA214 STEEL)	CORROSION ALLOWANCE	0.0625
PLUGS	.75" x 16 UNF3A x .75" LG. SHDR (SA-350-LF2 CLASS-1)	DESIGN CODE	2010 ASME SECTION VIII, DIV. 1, APPX. 13 & 28, NO AD.
COUPLING	1"-6000# (SA-350-LF2 CLASS-1)		
MACHINING		IMPACT EXEMPT	UCS-66(a) CURVE D, UCS-66(g) & UCS-68(c)
TUBE HOLES - DRILLED AND REAMED TO 0.633" ± .002"		P.W.H.T.	400F HEATING, .5 HR HOLD @ 1150F, 500F COOLING
TUBE HOLES - GROOVED PER TEMA-C 7.44		PREHEAT	NONE
PLUG HOLES - TAPPED FOR 0.75"-16 UNF-1B.		CHARPY IMPACT TEST	NONE

REV	DESCRIPTION	BY	CHK	DATE



CAN' REG' DWG. FOR: BOILER FEED WATER		DRAWN: JJ	CHECKED: JS
CUSTOMER MURPHY OIL		SCALE: NONE	
		DATE: 02/15/2012	
JOB NUMBER	SHEET	REV.	
118455	CRN1	0	

**AXH air-coolers**  
 401 EAST LOWRY ROAD, CLAREMORE, OK 74017  
 OF: 918-283-9200 / FX: 918-283-9229

**ASME PRESSURE VESSEL CODE SECTION VIII-DIVISION 1 (2010 EDITION, NO ADDENDA)**  
**STRESS CALCULATIONS FOR NON-REINFORCED RECTANGULAR CROSS SECTION HEADERS**  
**WRAPPER AS SHORT-SIDE PLATE / TUBE AND PLUG SHEET AS LONG-SIDE PLATE**

1	REFERENCE NAME   DATE   REF. NO.	VISTA PROJECTS / MURPHY OIL CORP.				02/15/12	118455
2	SERVICE NO.	1	2	3	4	5	
3	SERVICE LABEL	BF WATER					
4	SERVICE TAG NO.	118455.1					
5	SECTION DESIGN PRESSURE, ACTUAL   MAX	PSIG	P	256	256		
6	SECTION HYDRO TEST, MULTIPLIER   PSIG @ 100°F			1.3	333		
7	DESIGN TEMP, MAX   MIN	F		212	-50.0		
8	CORROSION ALLOWANCE	IN	CA	0.0625			
9	TUBE O.D.	IN		0.6250			
10	TUBE GAUGE	BWG		16			
11	TUBE MIN WALL THICKNESS	IN		0.0600			
12	TUBE MATERIAL	SA214 STEEL					
13	TUBE PITCH	IN	pt	1.5000			
14	TUBE VERTICAL SPACING	IN		1.299038			
15	SHLDR PLUG PITCH DIA.	IN	DE	0.7192			
16	TUBE ROWS	3					
17	FLANGE DIA	IN		3			
18	FLANGE CLASS	150RF					
20	NOZZLE TO HEADER CONNECTION TYPE	SET-ON PIPE					
19	NOZZLE CONNECTION SCH	S160					
20	NOZZLE CONNECTION, OD   AVG ID	IN		3.5000	2.6240		
21	WRAPPER SPAN	IN	H	2.5000			
22	TUBE/PLUG SPAN	IN	h	4.1250			
23	WRAPPER THICKNESS	IN	t1	0.5000			
24	TUBE/PLUG THICKNESS	IN	t2	1.0000			
25	END PLATE THICK, ACTUAL   MINIMUM	IN	ts	0.3750	0.3750		
26	OUTSIDE DIMENSIONS, WRAPPER   TUBE/PLUG	IN		4.5000	5.1250		
27	HEADER MATERIAL	SA516-70N					
28	FLANGE MATERIAL	SA350-LF2					
29	NOZZLE CONN. MATERIAL	SA333GR6					
30	END PLATE FACTOR/JOINT EFFICIENCY		C/E	0.2			
31	STRESS ALLOWABLE, HEADER MATERIAL	PSI	(S)h	20000			
32	STRESS ALLOWABLE, NOZZLE CONN.	PSI	(S)h	17100			
33	STRESS ALLOWABLE, TUBES	PSI	(S)t	13400			
34	PRESSURE MAX, HEADER BOX	PSIG		739			
35	PRESSURE MAX, FLANGE	PSIG		256			
36	PRESSURE MAX, NOZZLE CONN.	PSIG		3382			
37	PRESSURE MAX, TUBE	PSIG		3040			
38	ASME CALCULATIONS PER APPENDIX 13, FIG.13-2(a), SKETCH (1) AND CALCULATIONS PER APPENDIX 13 SECTION 13-7						
39	$(t1-CA)^{3/12}$		I1	0.0070			
40	$(t2-CA)^{3/12}$		I2	0.0687			
41	$(I2/I1)^a$		K	6.0774			
42	$3.4-2.4*((H+CA^2)/(h+CA^2))$ OR 2.5 MAX.		Z	1.9176			
43	$(H+CA^2)/(h+CA^2)$		a	0.6176			
44	$(t1-CA)/2$		c1	0.2188			
45	$(t2-CA)/2$		c2	0.4688			
46	$(pt-DE)/pt$		em,eb	0.5205			
47	STRESS TYPE AT ASME SECTION			STRESS PSI / % OF MAXIMUM STRESS (NOTE B)			
48	MEMBRANE STRESS - SHORT-SIDE (WRAPPER) / LONG-SIDE (TUBE/PLUG)			SHORT			
49	(1) $(P*(h+CA^2))/(2*(t1-CA))$	(Sm)N	1243	6%			
50	(2) $(P*(H+CA^2))/(2*em*(t2-CA))$	(Sm)M	689	3%			
51	BENDING STRESS - SHORT-SIDE (WRAPPER)						
52	(3) $((P*c1)/(12*I1))*(-1.5*(H+CA^2)^2+(h+CA^2)^2*(1+a^2*K))/(1+K)$	(Sb)N	1248	4%			
53	(4) $((P*(h+CA^2)^2*c1)/(12*I1))*((1+a^2*K)/(1+K))$	(Sb)Q	5664	19%			
54	BENDING STRESS - LONG-SIDE (TUBE/PLUG)						
55	(5) $((P*(h+CA^2)^2*c2)/(12*eb*I2))*(-1.5+(1+a^2*K)/(1+K))$	(Sb)M	5211	17%			
56	(6) $((P*(h+CA^2)^2*c2)/(12*I2))*((1+a^2*K)/(1+K))$	(Sb)Q	1233	4%			
57	TOTAL STRESS - SHORT-SIDE (WRAPPER)						
58	(7) EQ(1)+EQ(3)	(ST)N	2491	8%			
59	(8) EQ(1)+EQ(4)	(ST)Q	6907	23%			
60	TOTAL STRESS - LONG-SIDE (TUBE/PLUG)						
61	(9) EQ(2)+EQ(5)	(ST)M	5900	20%			
62	(10) EQ(2)+EQ(6)	(ST)Q	1922	6%			
63	STRESS - END PLATES PER UG-34(3)						
64	$P*Z*(C/E)*((H+CA^2)/(ts-CA))^2$	(S)EP	6928	35%			

(A) ALL DIMENSIONS ARE LISTED AS UNCORRODED. ALL STRESS CALCULATIONS ARE BASIS FULLY CORRODED DIMENSIONS.  
 (B) MAXIMUM STRESS IS ALLOWABLE HEADER STRESS (S)h FOR MEMBRANE AND END PLATES, 1.5 X (S)h FOR BENDING AND TOTAL STRESSES.